









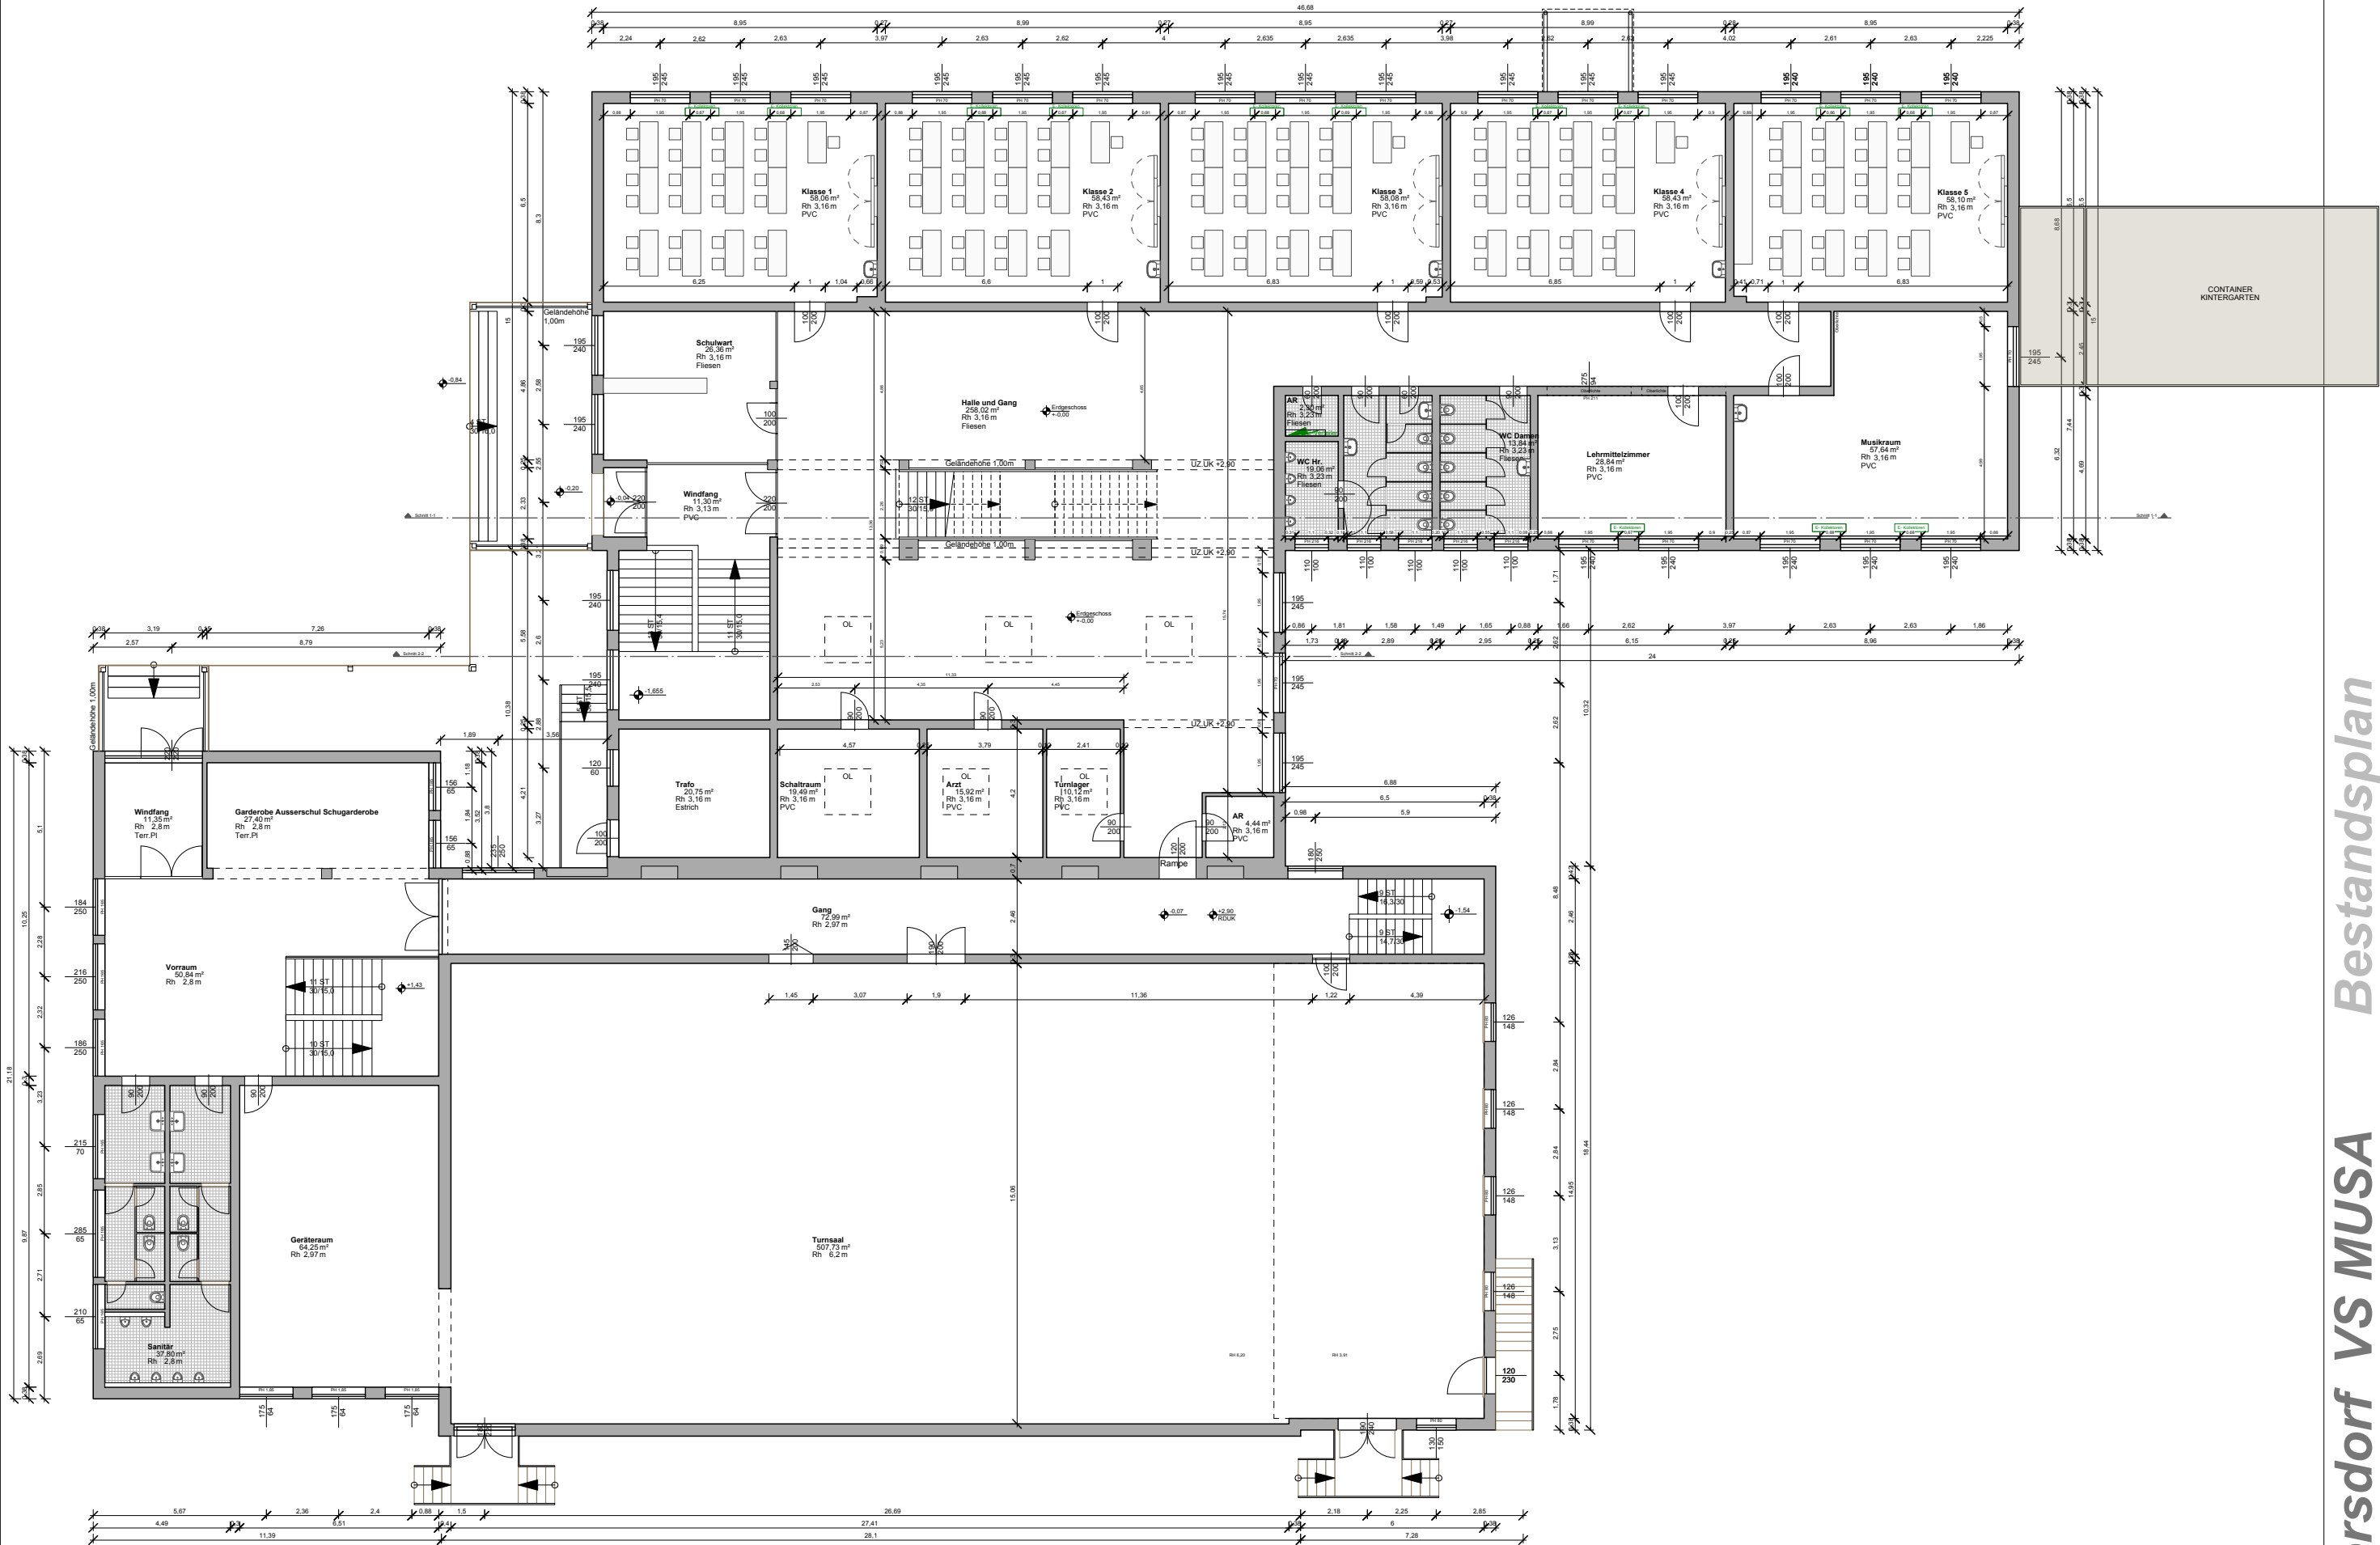

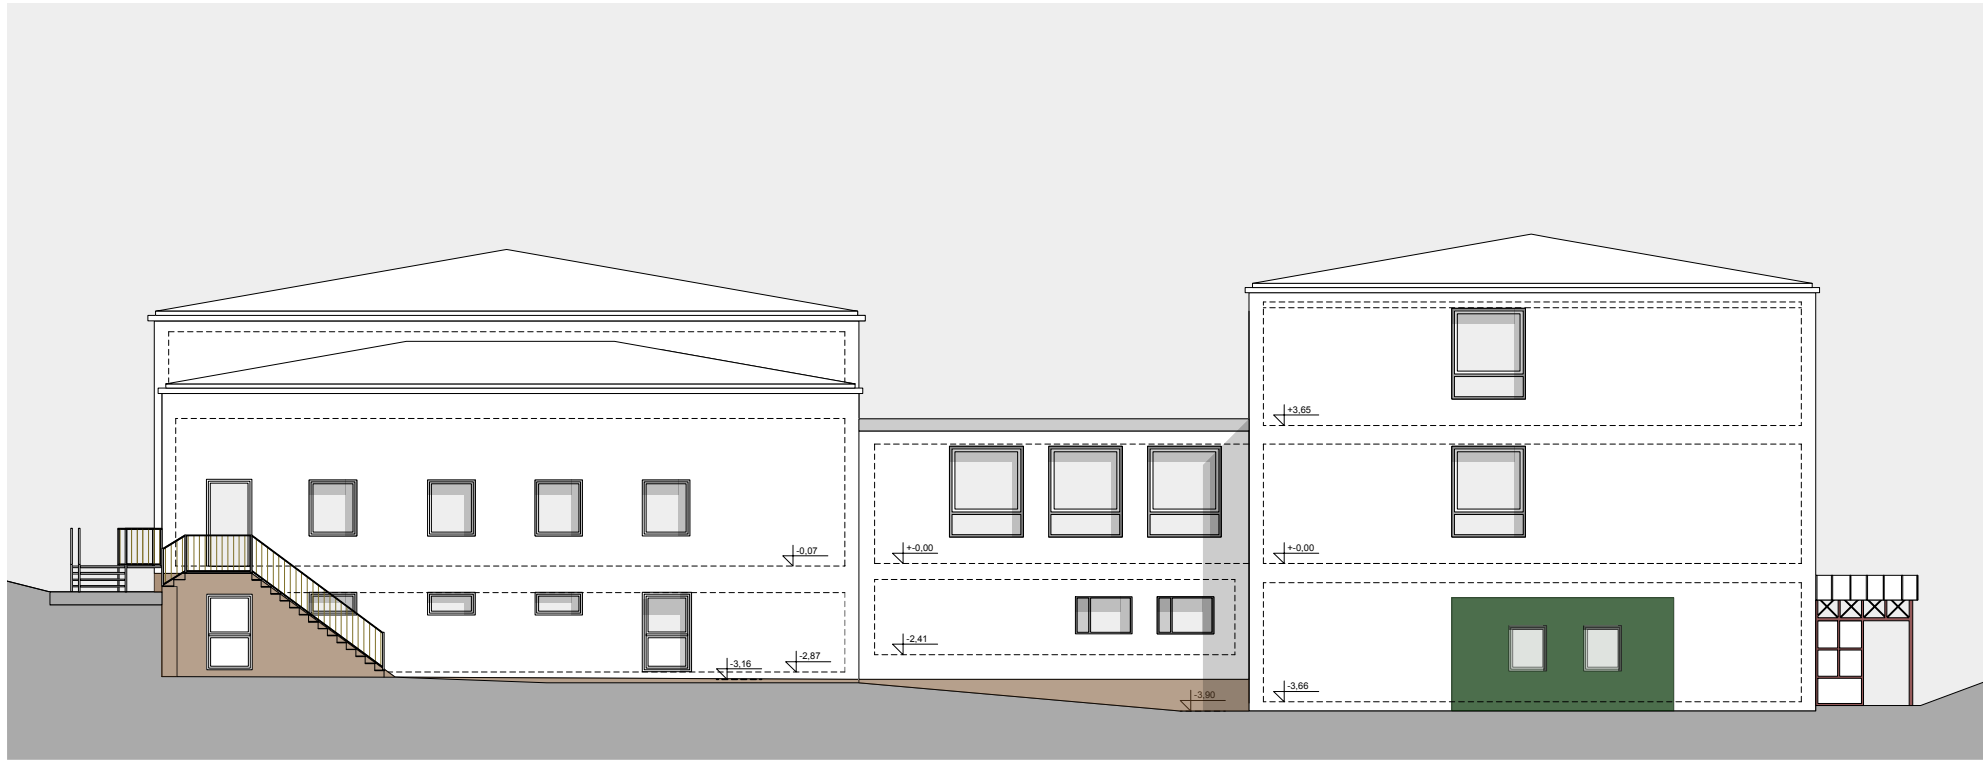

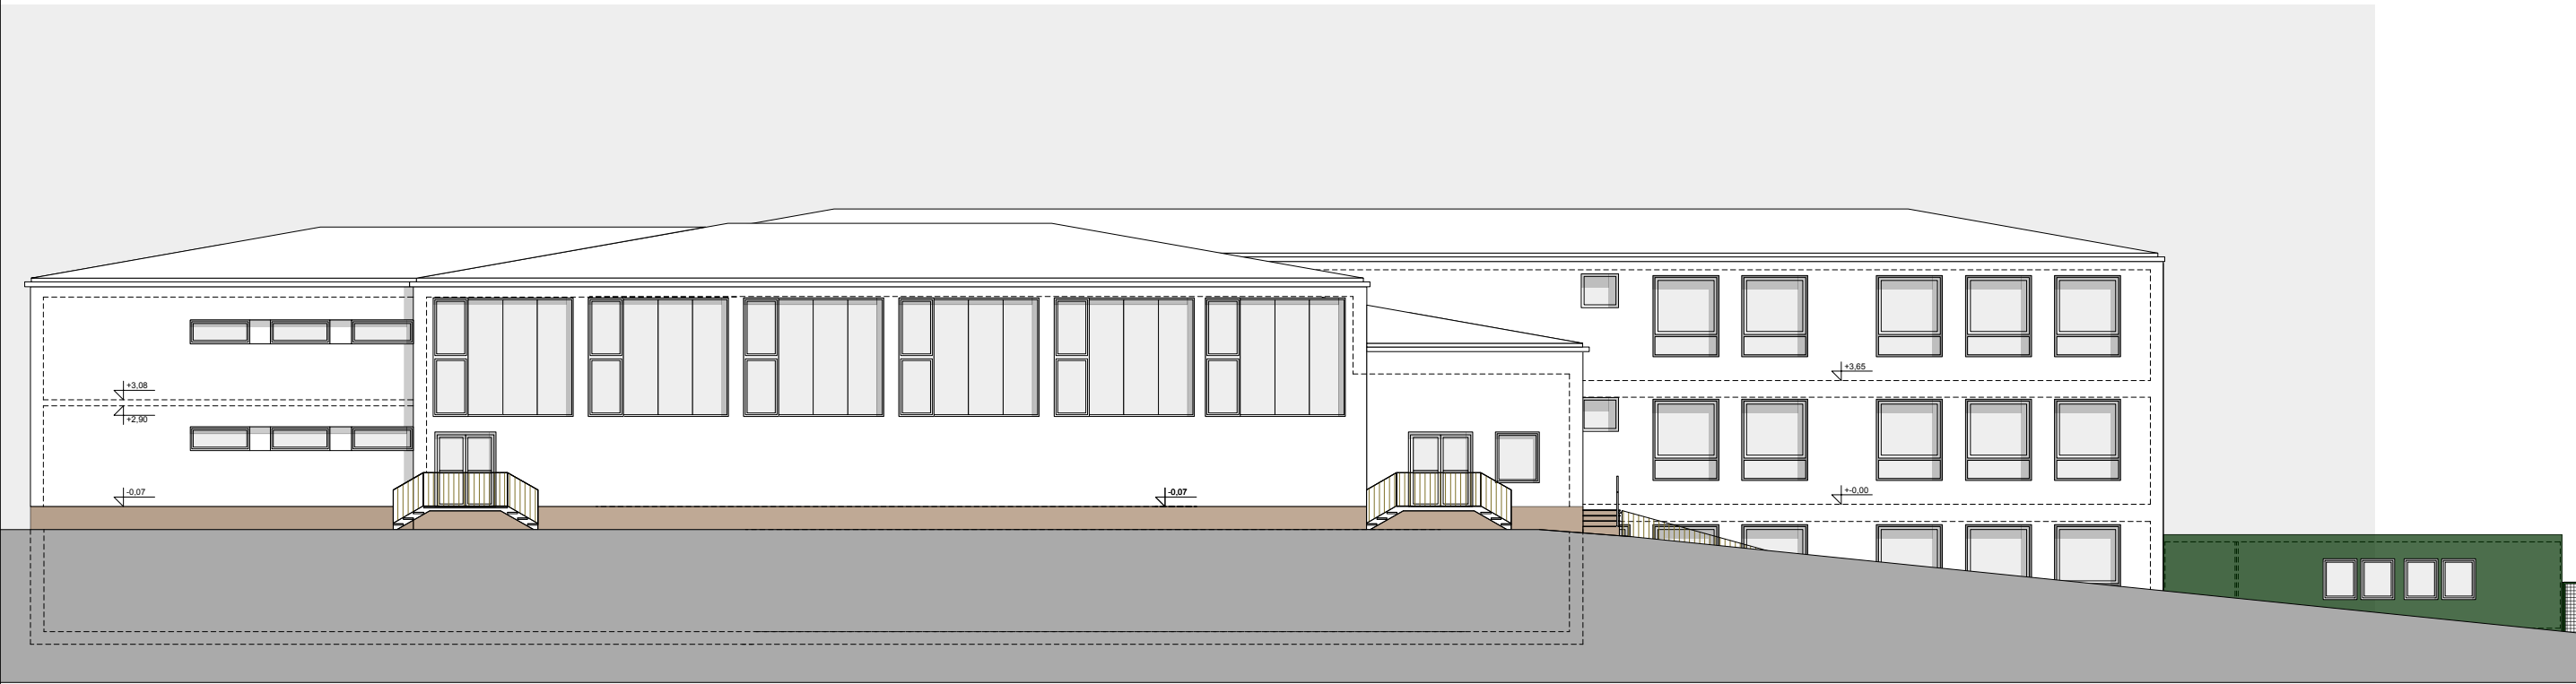

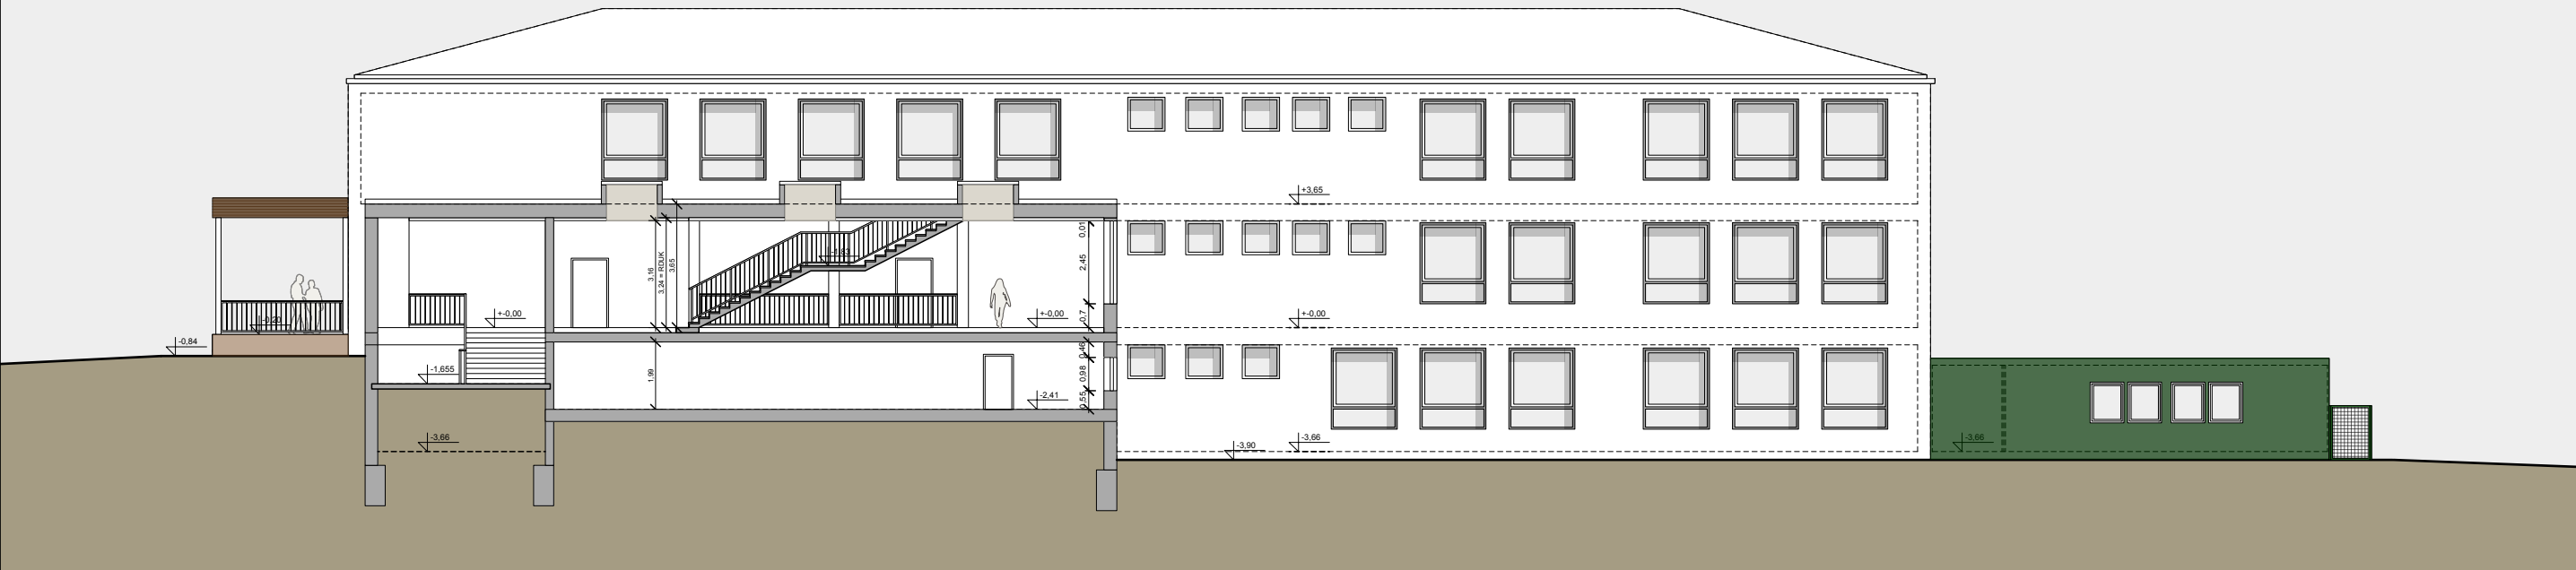

Bestandsplan



Ziersdorf VS MUSA